



"meeting community needs
.....enhancing quality of life"

REQUEST for Alcohol License Premise Amendment

FEES ARE NON-REFUNDABLE		Date Recv'd <u>6/7/23</u>
License Fee	\$10.00/event	Acct: CLCAGP
Receipt	<u>5187-5</u>	

SECTION 1 – LICENSE INFORMATION

Name of Establishment <u>STONE ARCH BREWPUB, INC.</u>	
Address of Establishment <u>1004 S. OLDE ONEIDA ST.</u>	
Name of Agent <u>STEVE LONSWAY</u>	Phone Number

SECTION 2 – PREMISE AMENDMENT

Please describe the change in premises:
 A drawing/diagram of the proposed area must also be submitted with this application
WE WISH TO UTILIZE OUR NORTH AREA FOR ~~LIVE MUSIC ON TUESDAYS~~
FROM 5 TO 11P (MUSIC ENDS AT 9P) AND DURING MILE OF MUSIC WEEK
2 DIAGRAMS ATTACHED

Is this change Permanent? <input type="checkbox"/> YES <input checked="" type="checkbox"/> NO	If this is temporary please specify the reason for the amendment: <u>mile of music</u>
--	---

Please list the date(s) and time(s) that this temporary premise amendment will be utilized:
~~TUESDAYS DURING SUMMER AND~~ MILE OF MUSIC DAY
AUG. 3 TO 6 NOON TO 11PM - FRI, FRI, SAT. - NOON TO 5PM SUN.

SECTION 3 – PENALTY NOTICE

I certify that I am familiar with Section 9-52 of the Municipal Code of the City of Appleton and agree that any license granted under this application may be suspended for cause at any time by the Common Council.
 Under penalty of law, I swear that the information provided in this application is true and correct to the best of my knowledge and belief.
 Signature of Applicant: St. Lonsway


FOR OFFICE USE ONLY

Department	Approve	Deny	By	Reason
Comm. Dev.				
Finance				
Fire				
Health				
Inspections				
Police				

S&L 06/28/2023	Council	Date Issued	Exp. Date	License Number
----------------	---------	-------------	-----------	----------------


BETWEEN THE LOCKS CONDOMINIUM

CITY OF APPLETON,
OUTAGAMIE COUNTY,
WISCONSIN

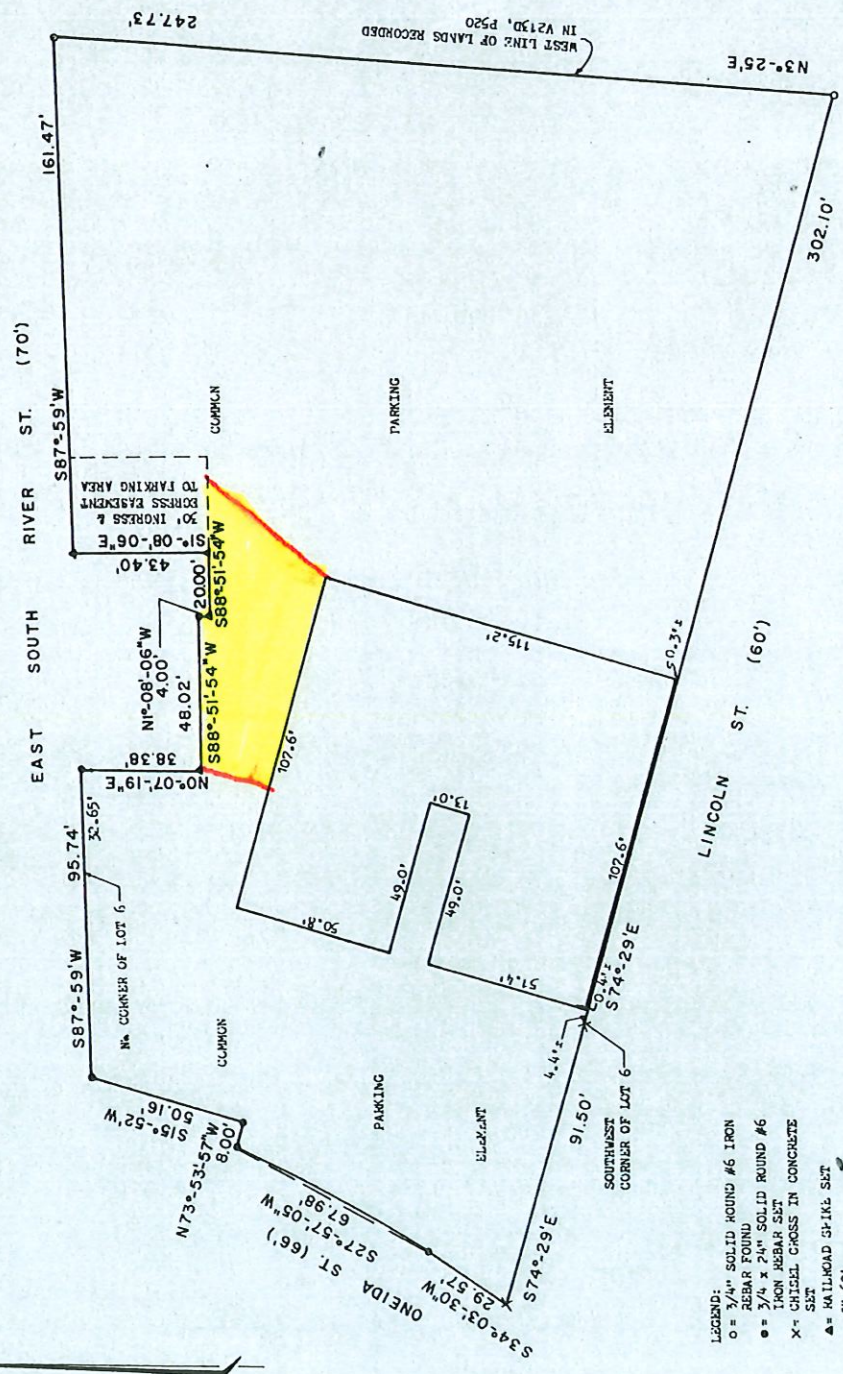


- LEGEND:
- = 3/4" SOLID ROUND #6 IRON
 - = 3/4" SOLID ROUND #6 REBAR
 - = 7/8" x 24" SOLID ROUND #6 IRON REBAR EXT.
 - X = CURBELL CROSS IN CONCRETE
 - ▲ = SET
 - △ = NAILHEAD SPIKE SET
 - 1" = 60'

CONDOMINIUM DESCRIPTION: PART OF VACATED ONEIDA STREET, ALL OF LOT SIX (6) AND PART OF LOT SEVEN (7), IN BLOCK THREE (3), EDWARD VESTAS FLAT AND PART OF BLOCK EIGHTY-THREE (83), FOURTH WARD RECORD, APPELLON, OUTAGAMIE COUNTY, WISCONSIN, ACCORDING TO THE RECORD ASSESSOR'S MAP OF SAID CITY, MORE FULLY DESCRIBED AS FOLLOWS: BEGINNING AT THE SOUTHWEST CORNER OF SAID LOT 6; THENCE S74°-29'E, 302.10 FEET ALONG THE NORTHERLY LINE OF EAST LINCOLN STREET TO THE WEST LINE OF LANDS RECORDED IN V213D, P520; THENCE N3°-25'E, 247.73 FEET ALONG SAID WEST LINE TO THE SOUTH LINE OF EAST SOUTH RIVER STREET; THENCE S87°-59'W, 161.47 FEET ALONG SAID SOUTH LINE; THENCE N1°-08'-06"W 4.00 FEET; THENCE S88°-51'-54"W, 20.00 FEET; THENCE S88°-51'-54"W 43.40 FEET; THENCE S88°-51'-54"W, 48.02 FEET; THENCE N73°-53'-57"W 8.00 FEET TO THE SOUTH LINE OF EAST SOUTH RIVER STREET; THENCE S87°-59'W 95.74 FEET ALONG SAID SOUTH LINE AND ITS WESTERLY EXTENSION TO THE EAST LINE OF LANDS OWNED BY THE U. S. GOVERNMENT; THENCE S15°-21'W, 50.16 FEET ALONG SAID EAST LINE TO THE SOUTH LINE OF LANDS OWNED BY THE U. S. GOVERNMENT; THENCE N73°-53'-57"W, 8.00 FEET ALONG SAID SOUTH LINE TO THE EASTERLY LINE OF PRESENT ONEIDA STREET; THENCE S27°-57'-05"W AND IS 67.98 FEET IN LENGTH TO THE TERMINATION OF BEARS ALONG THE ARC OF A CURVE OF SAID EASTERLY LINE ON A CHORD WHICH BEARS S27°-57'-05"W AND IS 67.98 FEET IN LENGTH TO THE TERMINATION OF SAID CURVE; THENCE S34°-03'-30"W, 29.57 FEET ALONG SAID EASTERLY LINE TO THE NORTH LINE OF LINCOLN STREET EXTENDED WESTERLY; THENCE S74°-29'E, 91.50 FEET ALONG SAID WESTERLY EXTENSION TO THE POINT OF BEGINNING. SUBJECT TO ALL EASEMENTS AND RESTRICTIONS OF RECORD.

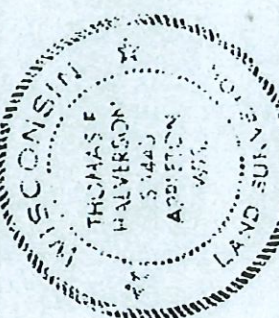

I, THOMAS F. HALVERSON, REGISTERED WISCONSIN LAND SURVEYOR, CERTIFY THAT THIS PLAT IS A CORRECT REPRESENTATION OF THE CONDOMINIUM DESCRIBED AND THAT THE IDENTIFICATION AND LOCATION OF EACH UNIT AND THE COMMON AREAS CAN BE DETERMINED FROM THE PLAT AND FLOOR PLANS.

Thomas F. Halverson
 THOMAS F. HALVERSON, RLS-1045
 CARON LAND SURVEYING CO., INC.
 P. O. BOX 1297
 APPLETON, WISCONSIN 54912-1297
 54272-B

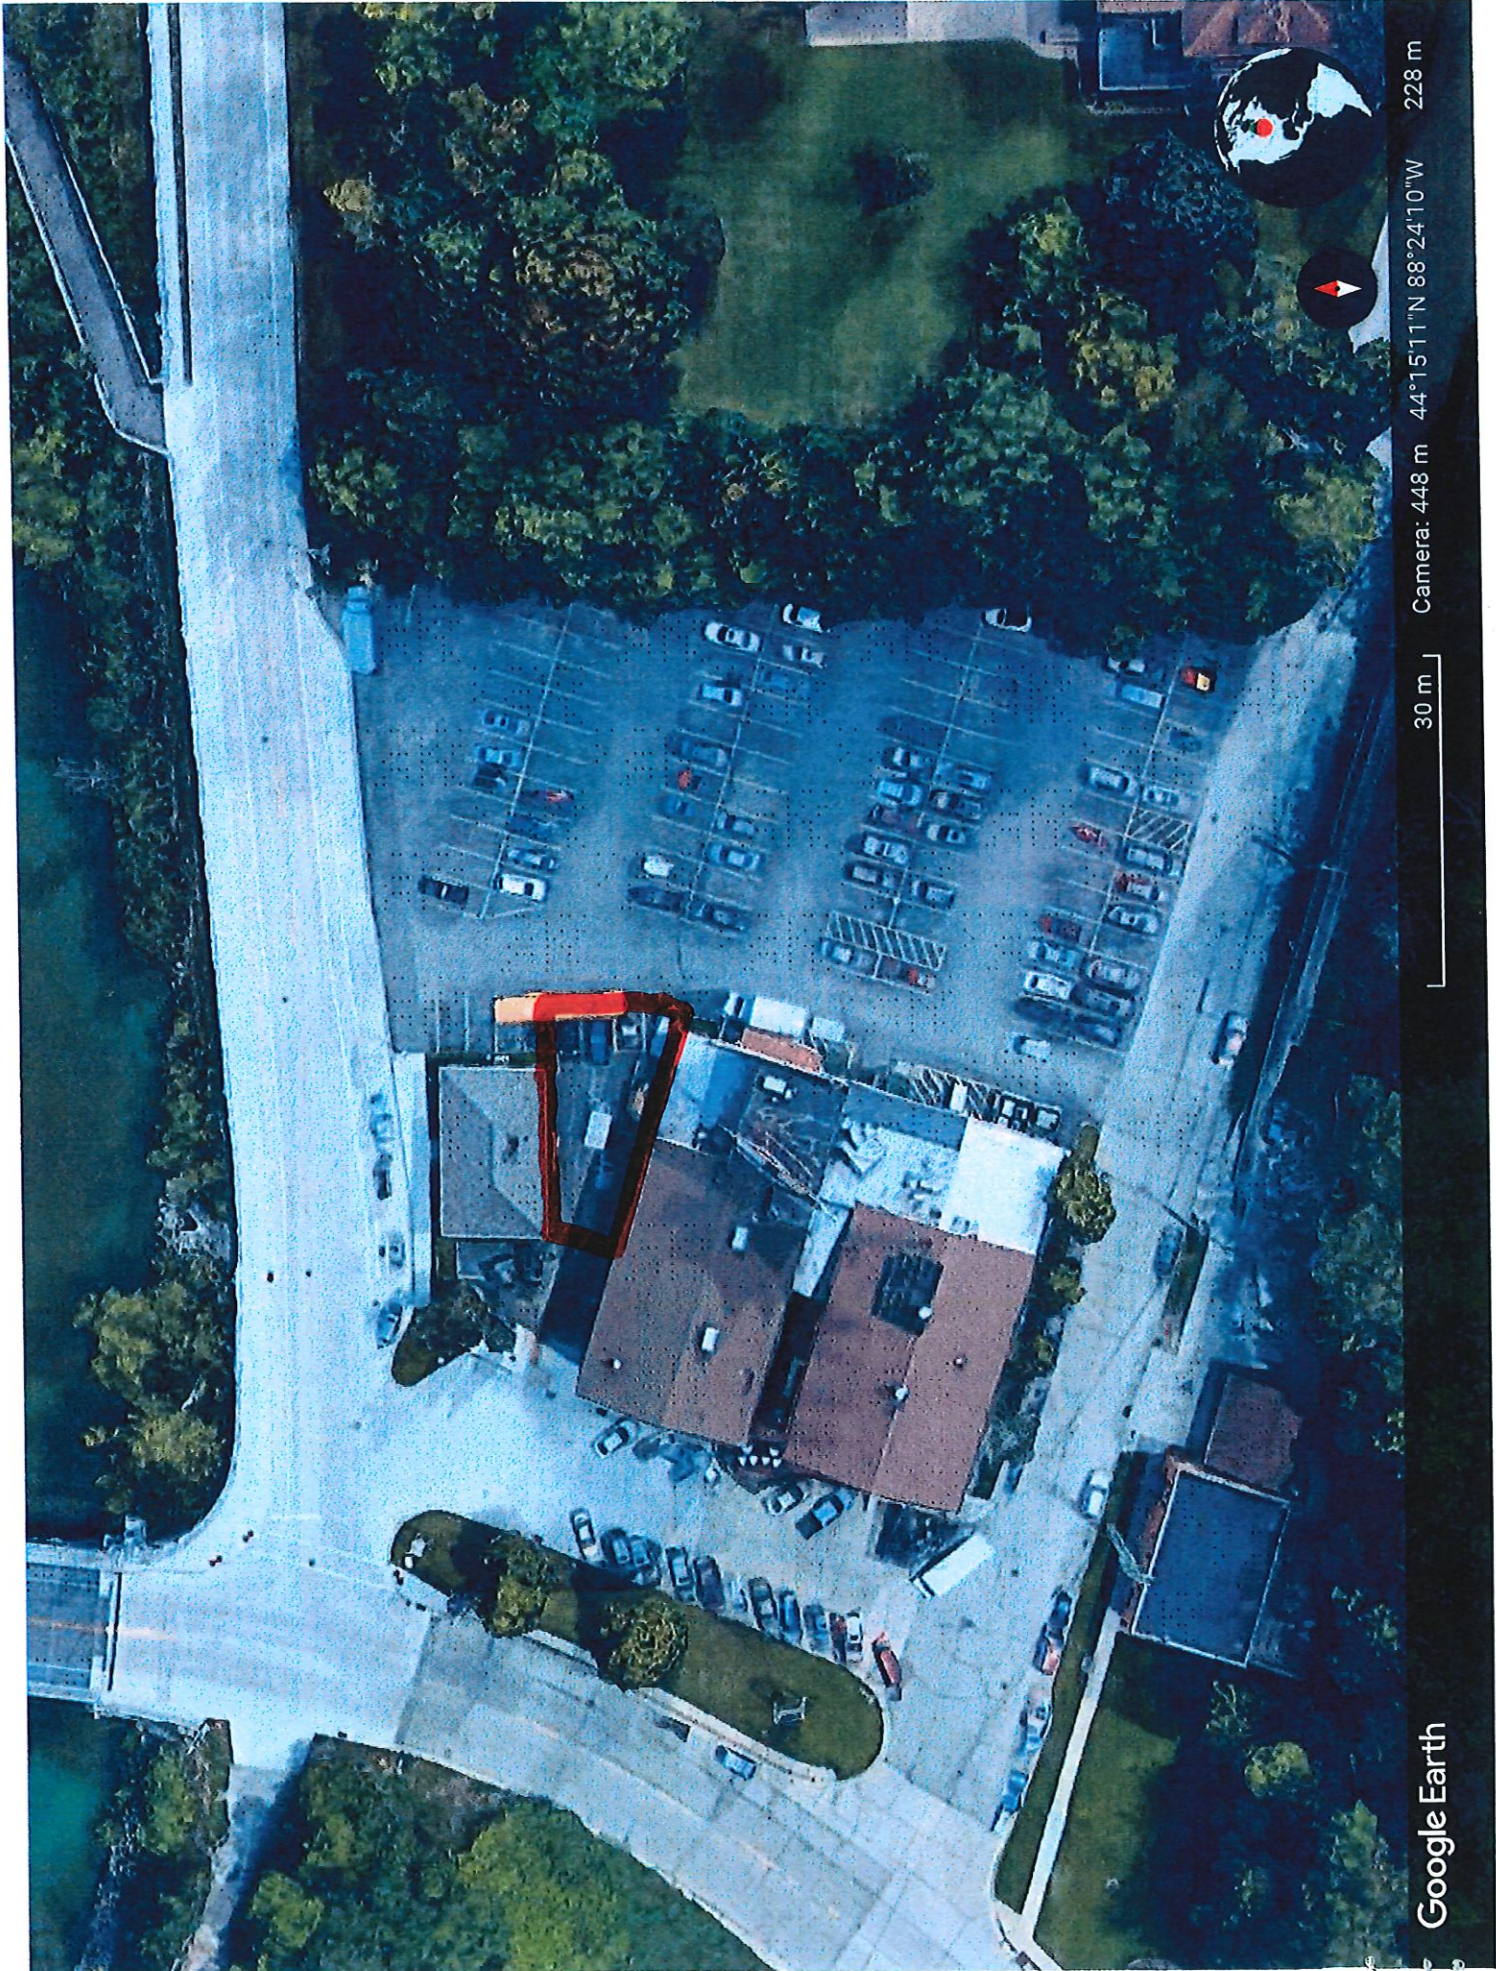

Google Earth

30 m

Camera: 448 m 44°15'11"N 88°24'10"W 228 m

