



"meeting community needs
.....enhancing quality of life"

REQUEST for Beer/Liquor License Premise Amendment

FEES ARE NON-REFUNDABLE	Date Rec'd <u>1/21/19</u>
License Fee \$10.00/event	Acct: CLCAGP
Receipt <u>3501</u>	

SECTION 1 – LICENSE INFORMATION				
Name of Establishment	<u>MIP, LLC /dba McGUINNESS IRISH PUB</u>			
Address of Establishment	<u>201 S. WALNUT - APPLETON</u>			
Name of Agent	<u>MATTHEW MILLER</u>			
Phone Number	<u>920-573-0959</u>			
SECTION 2 – PREMISE AMENDMENT				
Please describe the change in premises: *A drawing/diagram of the proposed area must also be submitted with this application*				
<u>CONSTRUCTION OF A PERMANENT BEER GARDEN WITH FENCING AND PLANTINGS</u>				
Is this change Permanent?	If this is temporary please specify the reason for the amendment:			
<input checked="" type="checkbox"/> YES <input type="checkbox"/> NO				
Please list the date(s) and time(s) that this temporary premise amendment will be utilized:				
SECTION 4 – PENALTY NOTICE				
I certify that I am familiar with Section 9-52 of the Municipal Code of the City of Appleton and agree that any license granted under this application may be suspended for cause at any time by the Common Council. Under penalty of law, I swear that the information provided in this application is true and correct to the best of my knowledge and belief.				
Signature of Applicant: <u>Matthew Miller</u>				
FOR OFFICE USE ONLY				
Department	Approve	Deny	By	Reason
Comm. Dev.				
Finance				
Fire				
Health				
Inspections				
Police				
S&L	Council	Date Issued	Exp. Date	License Number

PROPOSED BUILDING RENOVATION FOR MYSTIC IRELAND

APPLETON, WISCONSIN


SHEET INDEX

SHEET SHEET TITLE
C-5 GENERAL SHEET, INDEX, NOTES
SITE PLAN
ARCHITECTURAL
ELECTRICAL & SCHEDULES
A10 ADA DETAILS

PROJECT INFORMATION

CONSTRUCTION CLASSIFICATION ALTERATION
TYPE V6 NON-SPRINKLED LEVEL II ALTERATION
OCCUPANCY NON-SEPARATED MIXED USE EXISTING BUILDING CODE ITEMS
EXISTING ASSEMBLY 14,20 TABLE COMPARISONS
MERCANTILE 1M SIZE, HEIGHTS AND AREAS
EXISTING OCCUPANCY 1A PREVIOUS 1A
MERCANTILE 1M HAZARD THAN PREVIOUS 1A OCCUPANCY (LEVEL 2)
EXITTING HAZARD THAN PREVIOUS 1A OCCUPANCY (LEVEL 3)
CAPACITY HAZARD THAN PREVIOUS 1A OCCUPANCY (LEVEL 3)
MERCANTILE M - 3 PEOPLE

LOCATION MAP

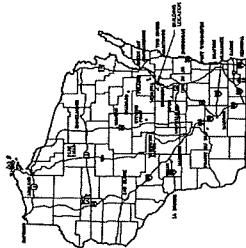

NOTE TO PLAN REVIEWER

NEW BUILDING OWNER IS GOING TO CONTINUE OPERATION OF A PORTION OF THE EXISTING BUILDING. THE EXISTING DINING AREA WILL BE RECONFIGURED INTO A STORE. OWNERSHIP OF BOTH BUSINESS OPERATIONS WILL BE BY THE SAME OWNER. THE ONLY WORK TO BE DONE IS TO PROVIDE CONTROL POINT FROM THE 1A-2 SPACE TO THE NEWLY CREATED RETAIL AREA.

GENERAL NOTES


- THESE DRAWINGS COVER STRUCTURAL AND GENERAL CONSTRUCTION WORK ONLY. ALL WORK SHALL conform to STATE AND LOCAL CODES UNLESS OTHERWISE NOTED ON THE DRAWINGS, AND SHALL BE DONE IN A WORKMANLIKE MANNER.
- THE CONTRACTOR SHALL FURNISH ALL MATERIALS AND LABORERS TO COMPLETE THE WORK. THE CONTRACTOR SHALL VERIFY THE LOCATION AND DIMENSIONS OF EXISTING STRUCTURAL MEMBERS AND REINFORCEMENTS NOT SHOWN ON THE STRUCTURAL DRAWINGS.
- OPENINGS SHOWN ON THE STRUCTURAL DRAWINGS SHALL NOT BE REISED WITHOUT WRITTEN APPROVAL FROM THE ARCHITECT.
- ALL CONCRETE AND MASONRY SHALL BE DONE IN ACCORDANCE WITH THE TYPICAL DETAILS SHOWN ON THE DRAWINGS.
- THE CONTRACTOR SHALL BE SOLELY RESPONSIBLE FOR OBTAINING ALL NECESSARY PERMITS AND APPROVALS FROM THE APPROPRIATE AGENCIES.
- THE CONTRACTOR SHALL BE SOLELY RESPONSIBLE FOR OBTAINING ALL NECESSARY PERMITS AND APPROVALS FROM THE APPROPRIATE AGENCIES.

751 MARCELLA STREET
KOSKIELLY, WI 53122
TEL: 920-974-2827 FAX: 920-974-2860



APPLETON, WISCONSIN
MYSTIC IRELAND
PROPOSED BUILDING RENOVATION FOR

50

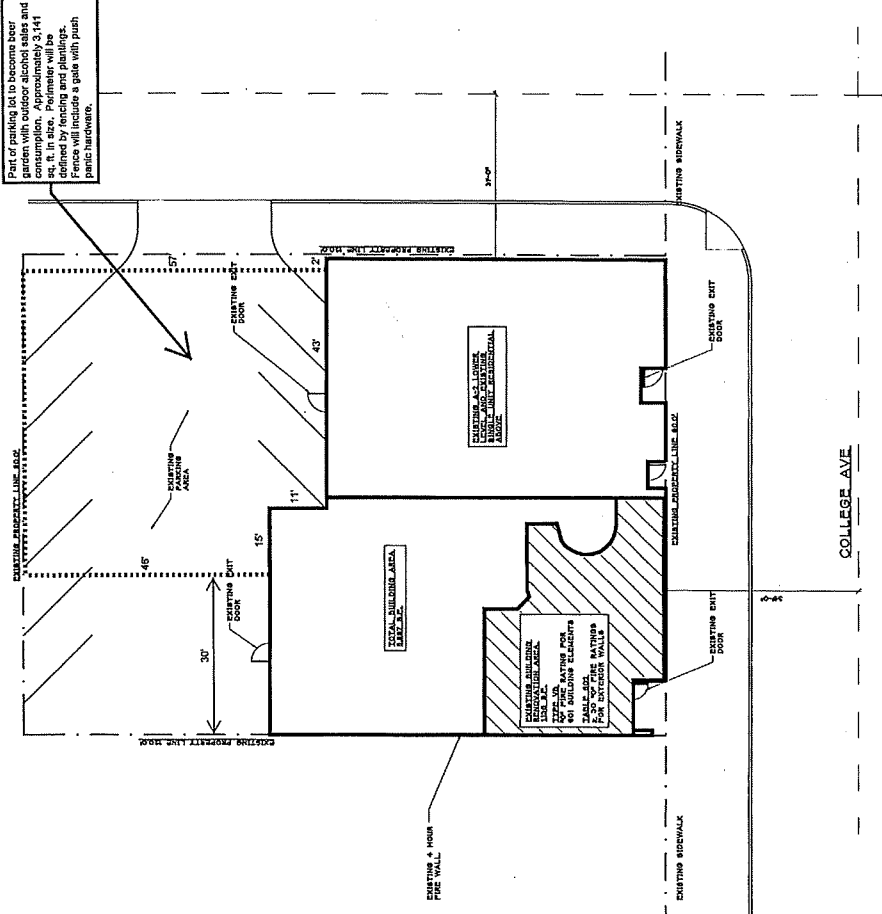

EXISTING SITE PLAN
SCALE: 1/8" = 1'-0"
TO BE USED FOR REFERENCE ONLY